


ENLARGED EQUIPMENT ENCLOSURE POWER PLAN

SCALE: 1/4" = 1'-0" 1

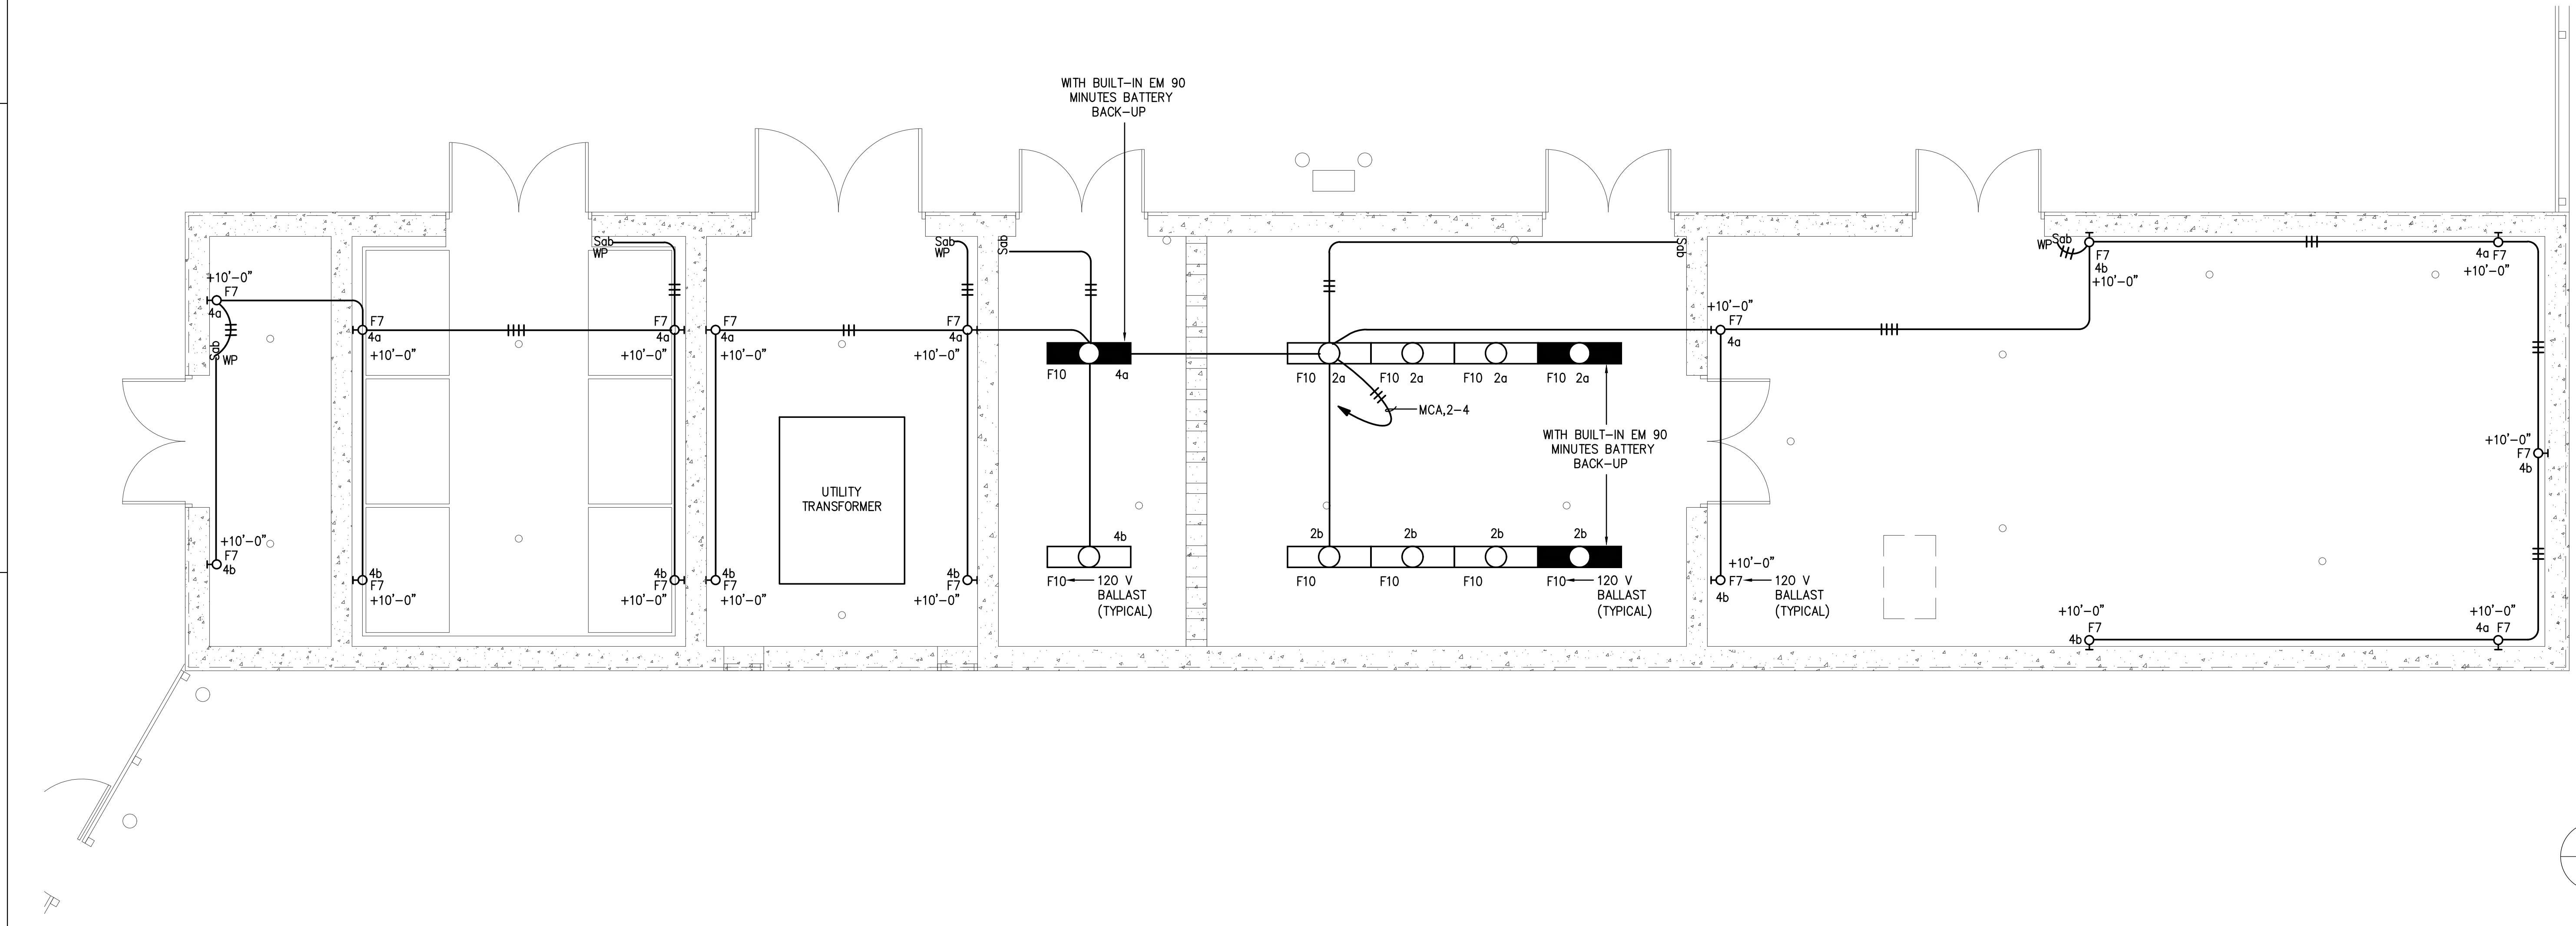


ENLARGED EQUIPMENT ENCLOSURE LIGHTING PLAN

SCALE: 1/4" = 1'-0" 2

REVISIONS	DATE
ADDENDUM #1	9/15/11
BUILT AS SHOWN	KH
05/13/16	

PROJECT RECORD DRAWINGS
GILBANE BUILDING COMPANY
ADMINISTRATIVE OFFICE OF THE COURTS
PROJECT NO. 1015766

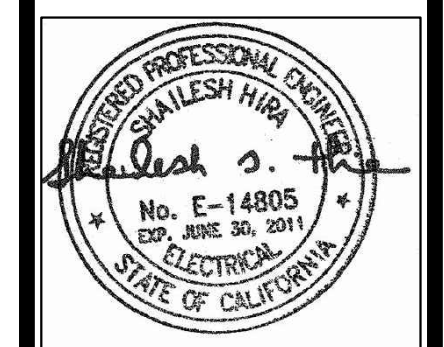

M-E Engineers, Inc.
10113 Jefferson Blvd.
Culver City, CA 90230
www.me-engineers.com

me
engineers

R. L. BINDER FAIA ARCHITECTS, LLP
7726 81st STREET
PLAYA DEL REY, CA 90233
(310) 301-0260

BANNING JUSTICE CENTER
311 E. RAMSEY STREET, BANNING, CA 92220
JUDICIAL COUNCIL OF CALIFORNIA
ADMINISTRATIVE OFFICE OF THE COURTS

TITLE
EQUIPMENT ENCLOSURE ELECTRICAL PLAN

DRAWN
CHECKED 200705
DATE 05/31/2011
SCALE
JOB NO. 200705
SHEET